
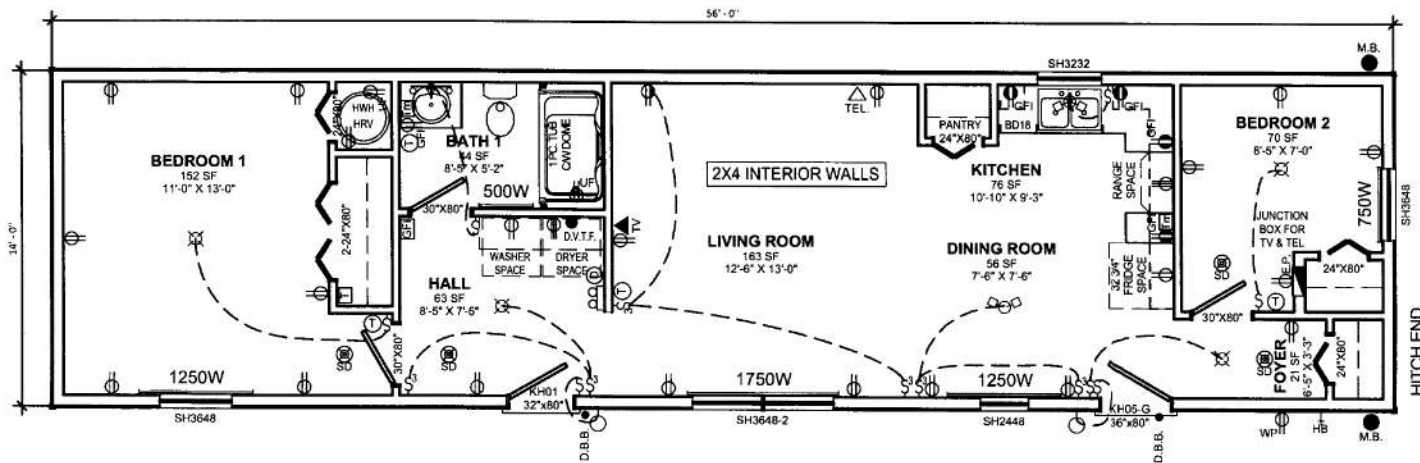



THE 'MAHONE' MODEL

14 X 56

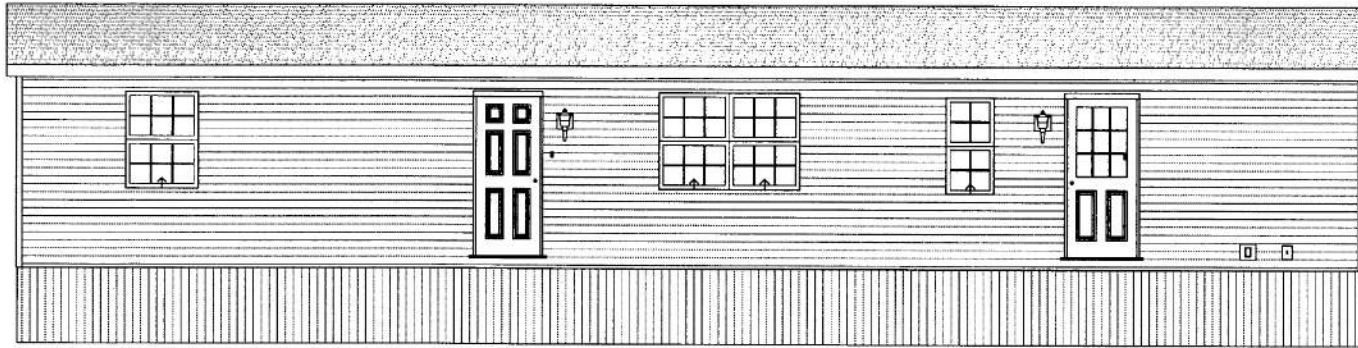

DRAWN BY:	FILE NO:	CLIENT:	 <p>Kent Homes It makes beautiful sense</p>
DATE: JUNE 16, 2014		HAVILL'S - STOCK	
SCALE: N.T.S.	CHK BY: ENG.	TITLE: AS BUILT DRAWINGS - FLOOR PLAN & FRONT ELEVATION 14'-0" X 56'-0" MINI	

2 Bedrooms