
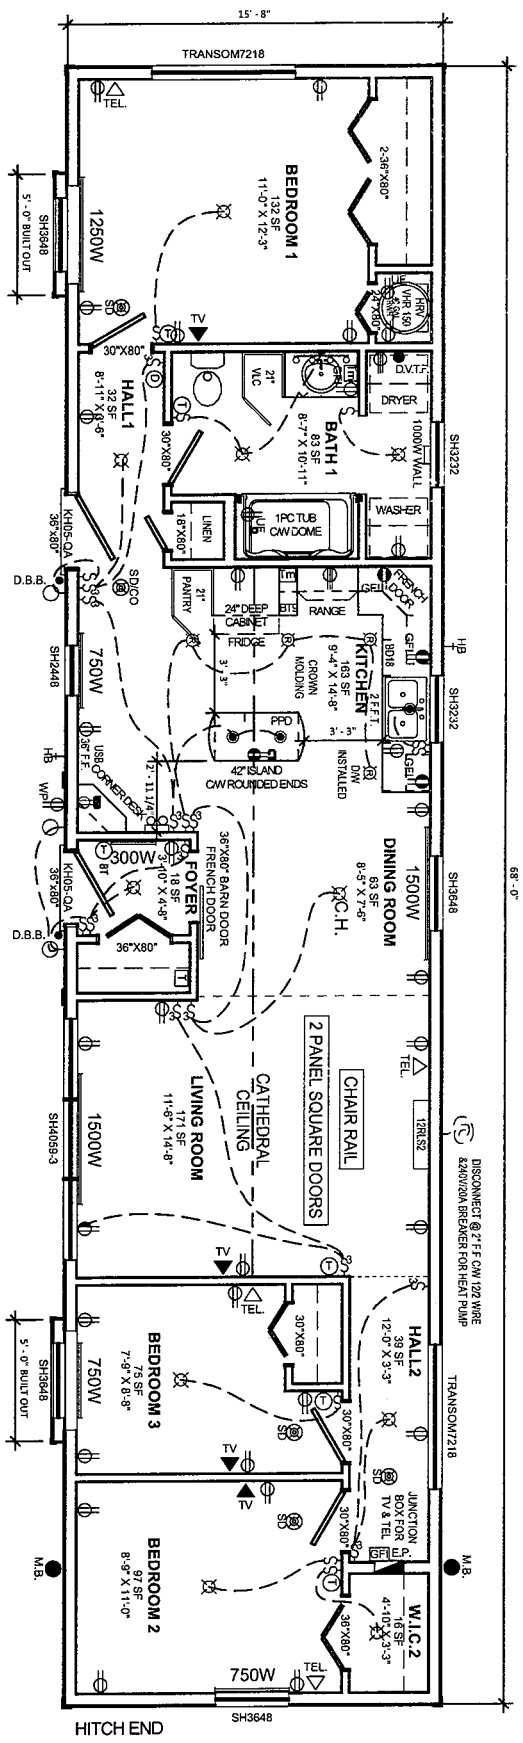


SAMBRO MODEL

16 X 68

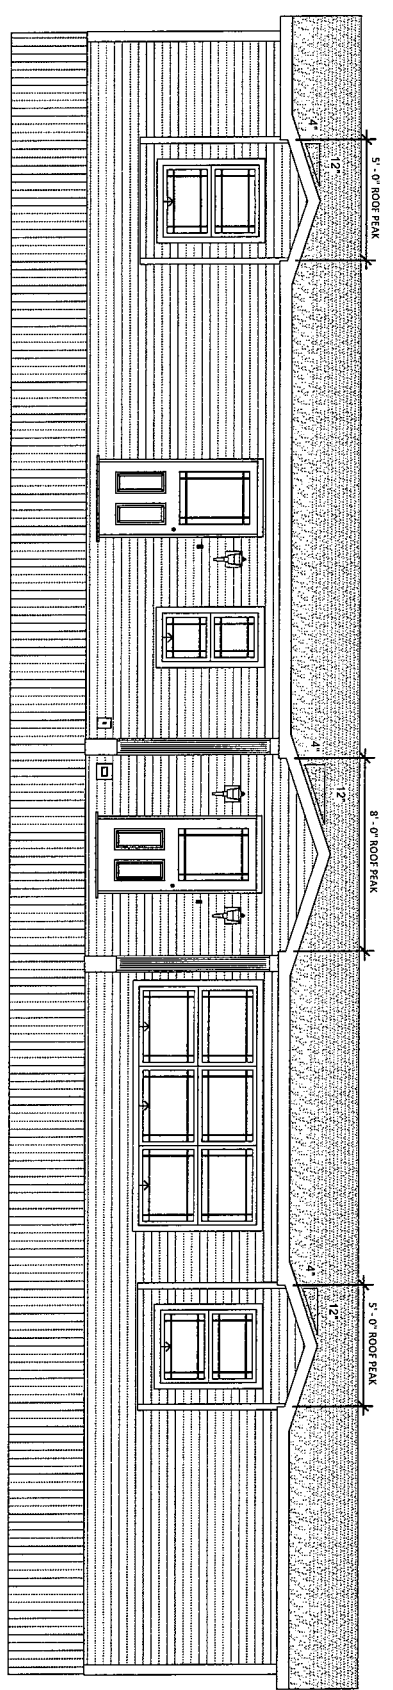

DRAWN BY: DATE: JUNE 18, 2015 SCALE: N.T.S.	FILE NO.: CHK BY: ENG.	CLIENT: HAVILL'S - STOCK #4 TITLE: REVISED AS BUILT DRAWING - FLOOR PLAN & FRONT ELEVATION 15'-8" X 68'-0" MINI	<p>Kent Homes It makes beautiful sense</p>
---	---------------------------	---	---

3 Bedrooms