QUEENSLAND MODEL

16 X 67

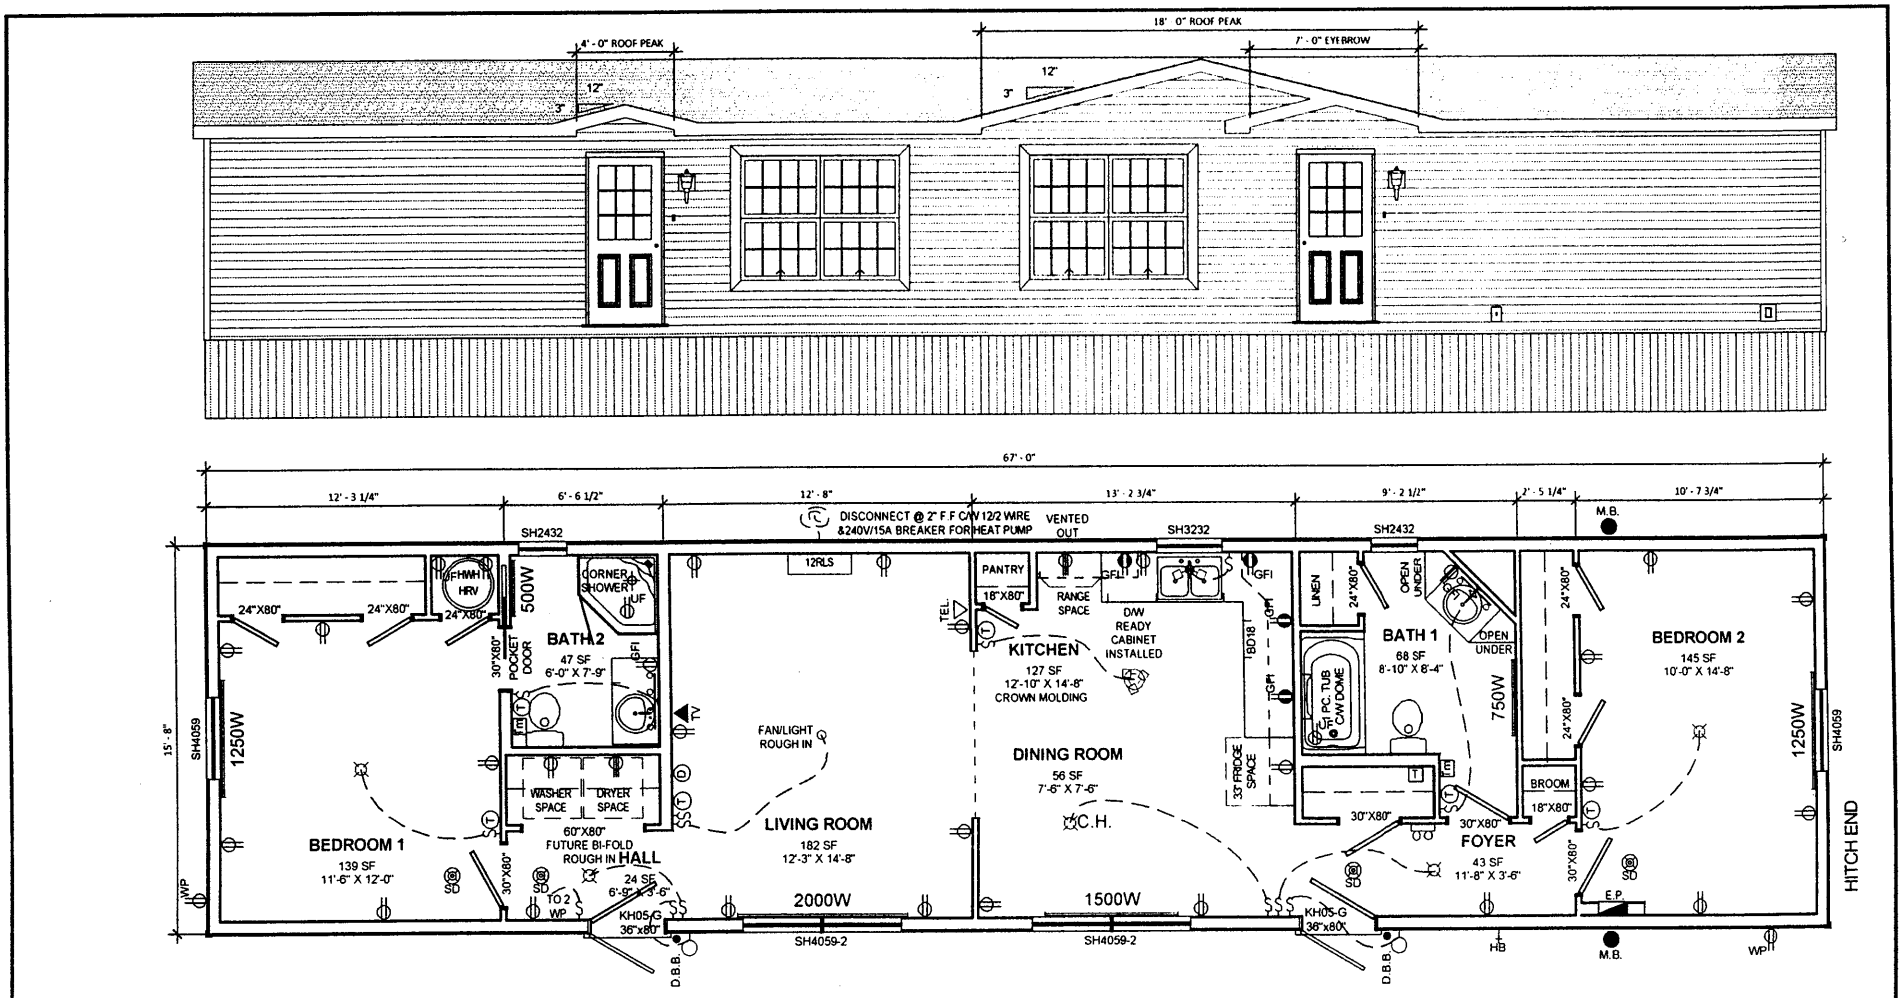

DRAWN BY:	FILE NO:	CLIENT: HAVILL'S - STOCK	Kent Homes
DATE:		TITLE: AS BUILT DRAWING - FLOOR PLAN & FRONT ELEVATION	It makes beautiful sense
SCALE: N.T.S.	CHK BY: ENG.	15'-8" X 67'-0" MINI	

2 Bedrooms, 2 Bathrooms