BAYFIELD MODEL

16 X 60

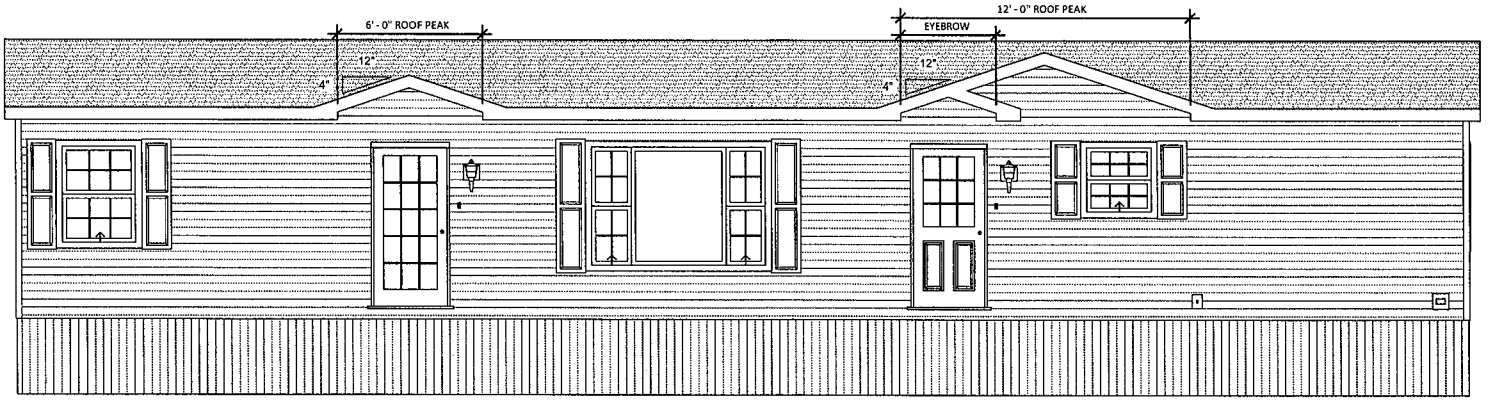

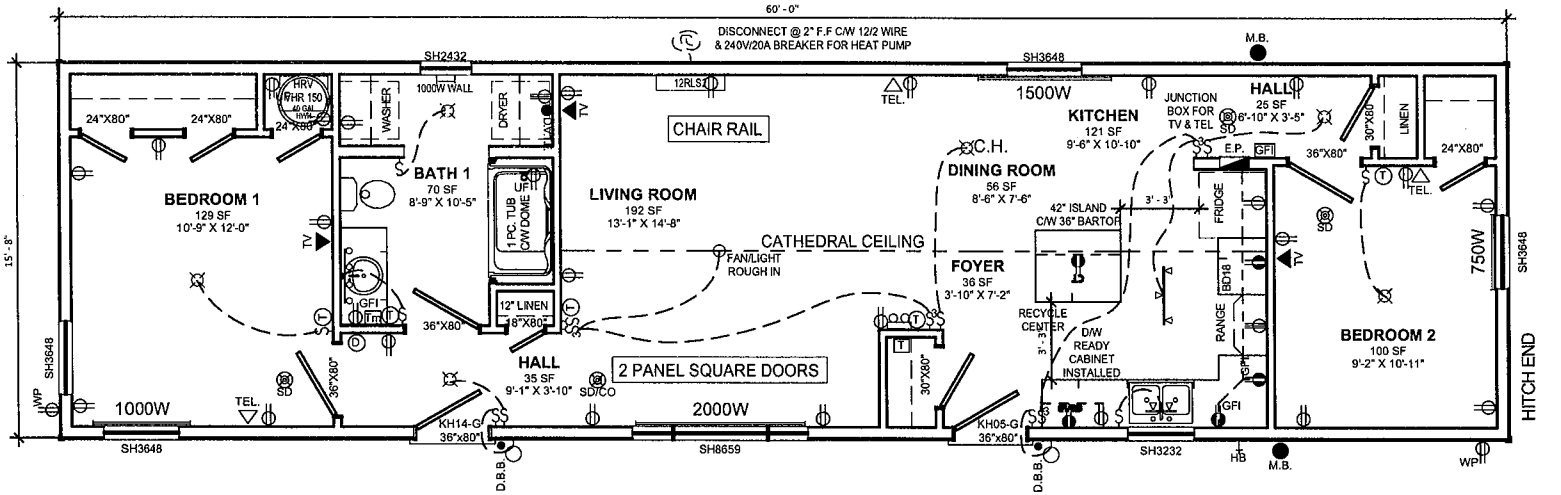

DRAWN BY:	FILE NO:	CLIENT: HAVILL'S - STOCK #3	Kent Homes It makes beautiful sense
DATE: JUNE 17_2015		TITLE: REVISED AS BUILT DRAWING - FLOOR PLAN & FRONT ELEVATION 15'-8" X 60'-0" MINI	
SCALE: N.T.S.	CHK BY: ENG.		

2 Bedrooms