BLOMIDON MODEL

16 X 64

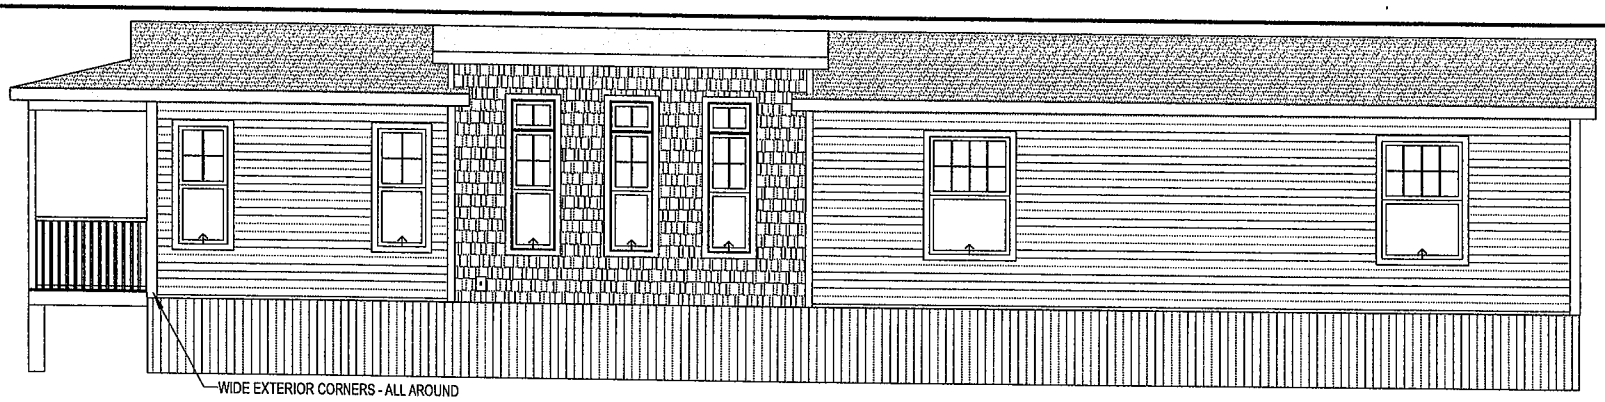

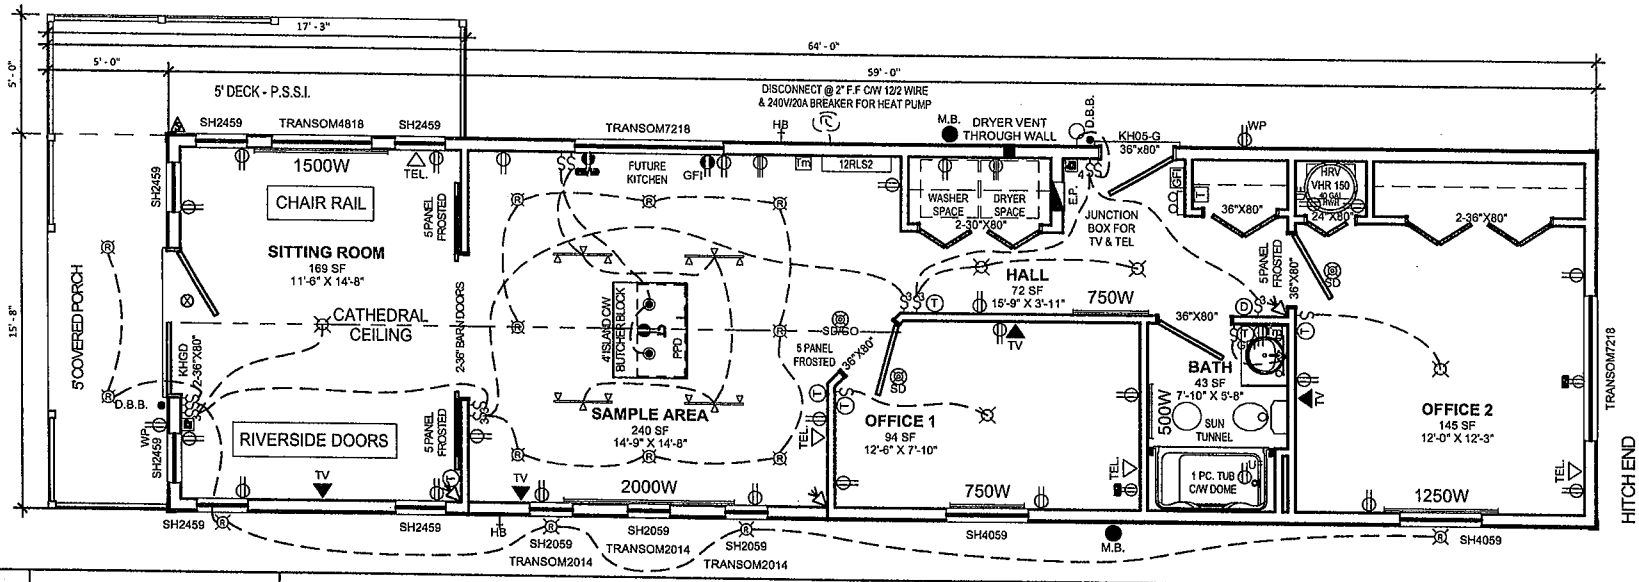

DRAWN BY:	FILE NO:	CLIENT: HAVILL'S - DESIGN CENTER	Kent Homes It makes beautiful sense
DATE:		TITLE: REVISED AS BUILT DRAWING - FLOOR PLAN & FRONT ELEVATION 15'-8" X 64'-0" MINI	
SCALE:	CHK BY: ENG.		

2 Bedrooms