DUPUIS MODEL
16 X 74

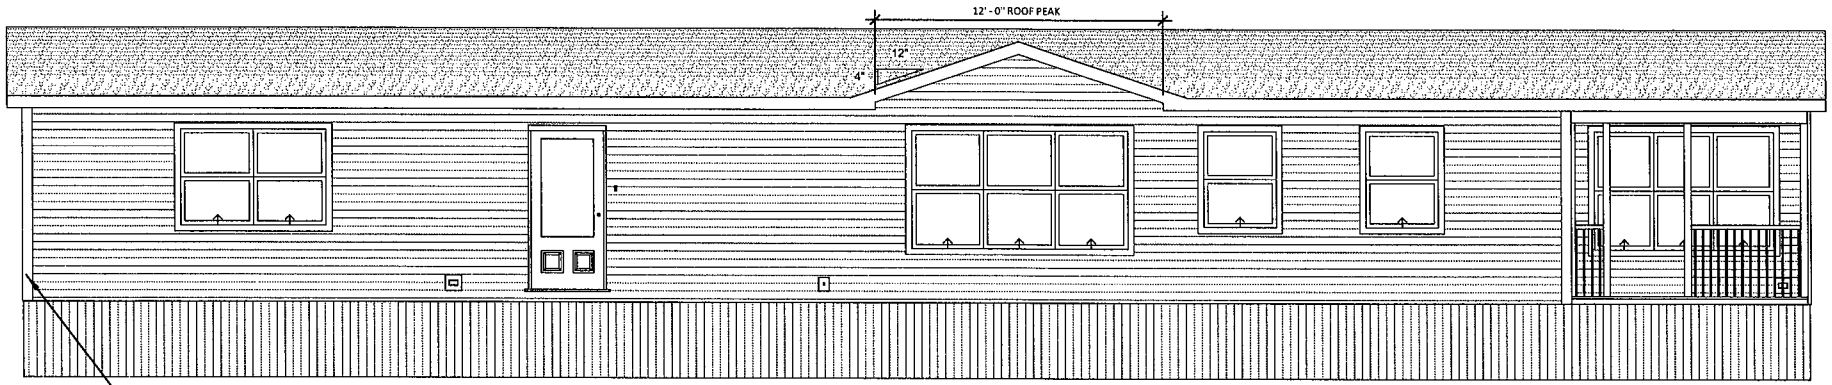

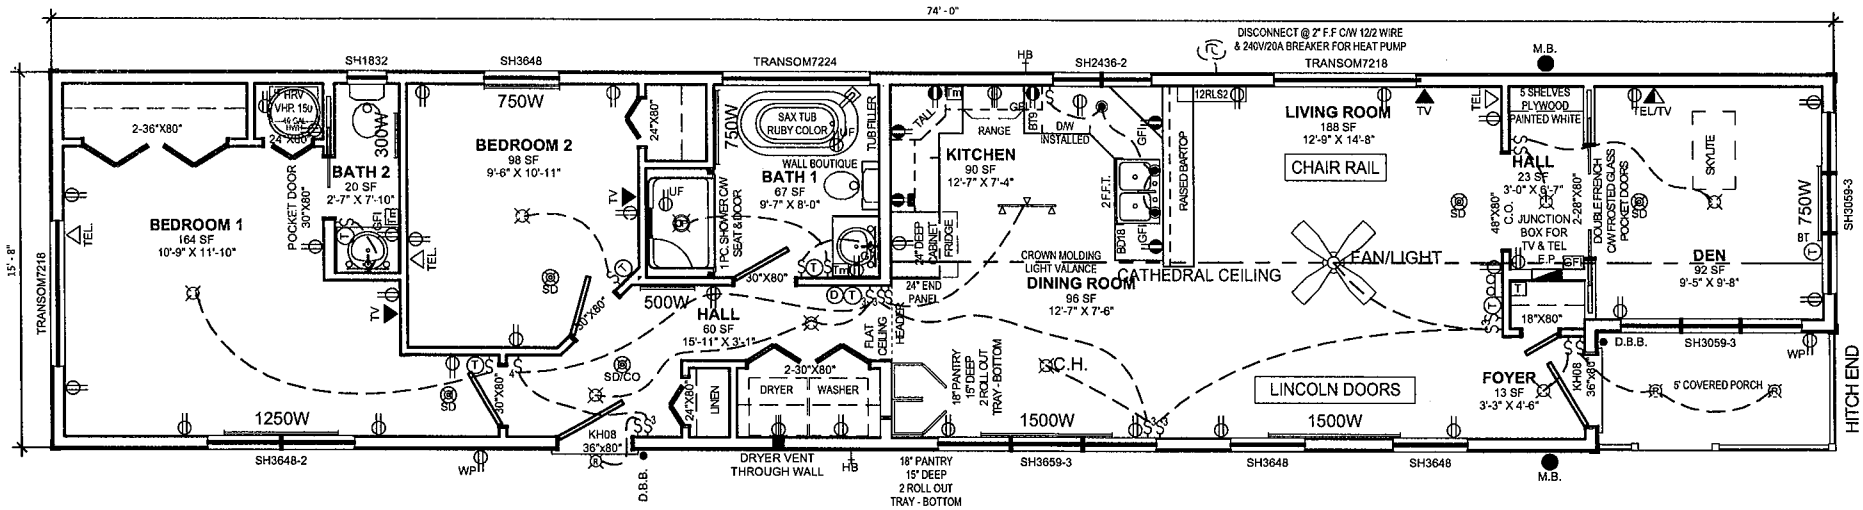

DRAWN BY:	FILE NO:	CLIENT: HAVILL'S - STOCK #2	Kent Homes It makes beautiful sense
DATE: JUNE 18_2015		TITLE: REVISED AS BUILT DRAWING - FLOOR PLAN & FRONT ELEVATION 15'-8" X 74'-0" MINI	
SCALE: N.T.S.	CHK BY: ENG.		

2 Bedrooms, 2 Bathrooms